

Auditor File #: **2003 0011060**

Recorded at the request of:

TODD, THOMAS E.

on **08/14/2003** at **15:02**

Total of **6** page(s) Paid: \$ **110.00**
STEVENS COUNTY, WASHINGTON
TIM GRAY, AUDITOR

AGAGNON

SURVEY

OWNERS **EUGENE R. SPRING**

TO SURVEY **THOMAS E. TODD**
FILED BY

SURVEYOR **THOMAS E. TODD**

SURVEY BOOK **23** PAGE **97, 98, 99, 100, 101 & 102**

FEE\$ **50.50** DNR\$ **46.00**

CS \$ **2.00** SAF\$ **2.00**

LOW INCOME HOUSING \$ **9.50**


LEGAL DESCRIPTION: SECTION **18** TWP **37** RGE **39**

LEGAL DESCRIPTION: SECTION **19** TWP **37** RGE **39**

LEGAL DESCRIPTION: SECTION _____ TWP _____ RGE _____

LEGAL DESCRIPTION: SECTION _____ TWP _____ RGE _____

ADDITIONAL INFORMATION: _____

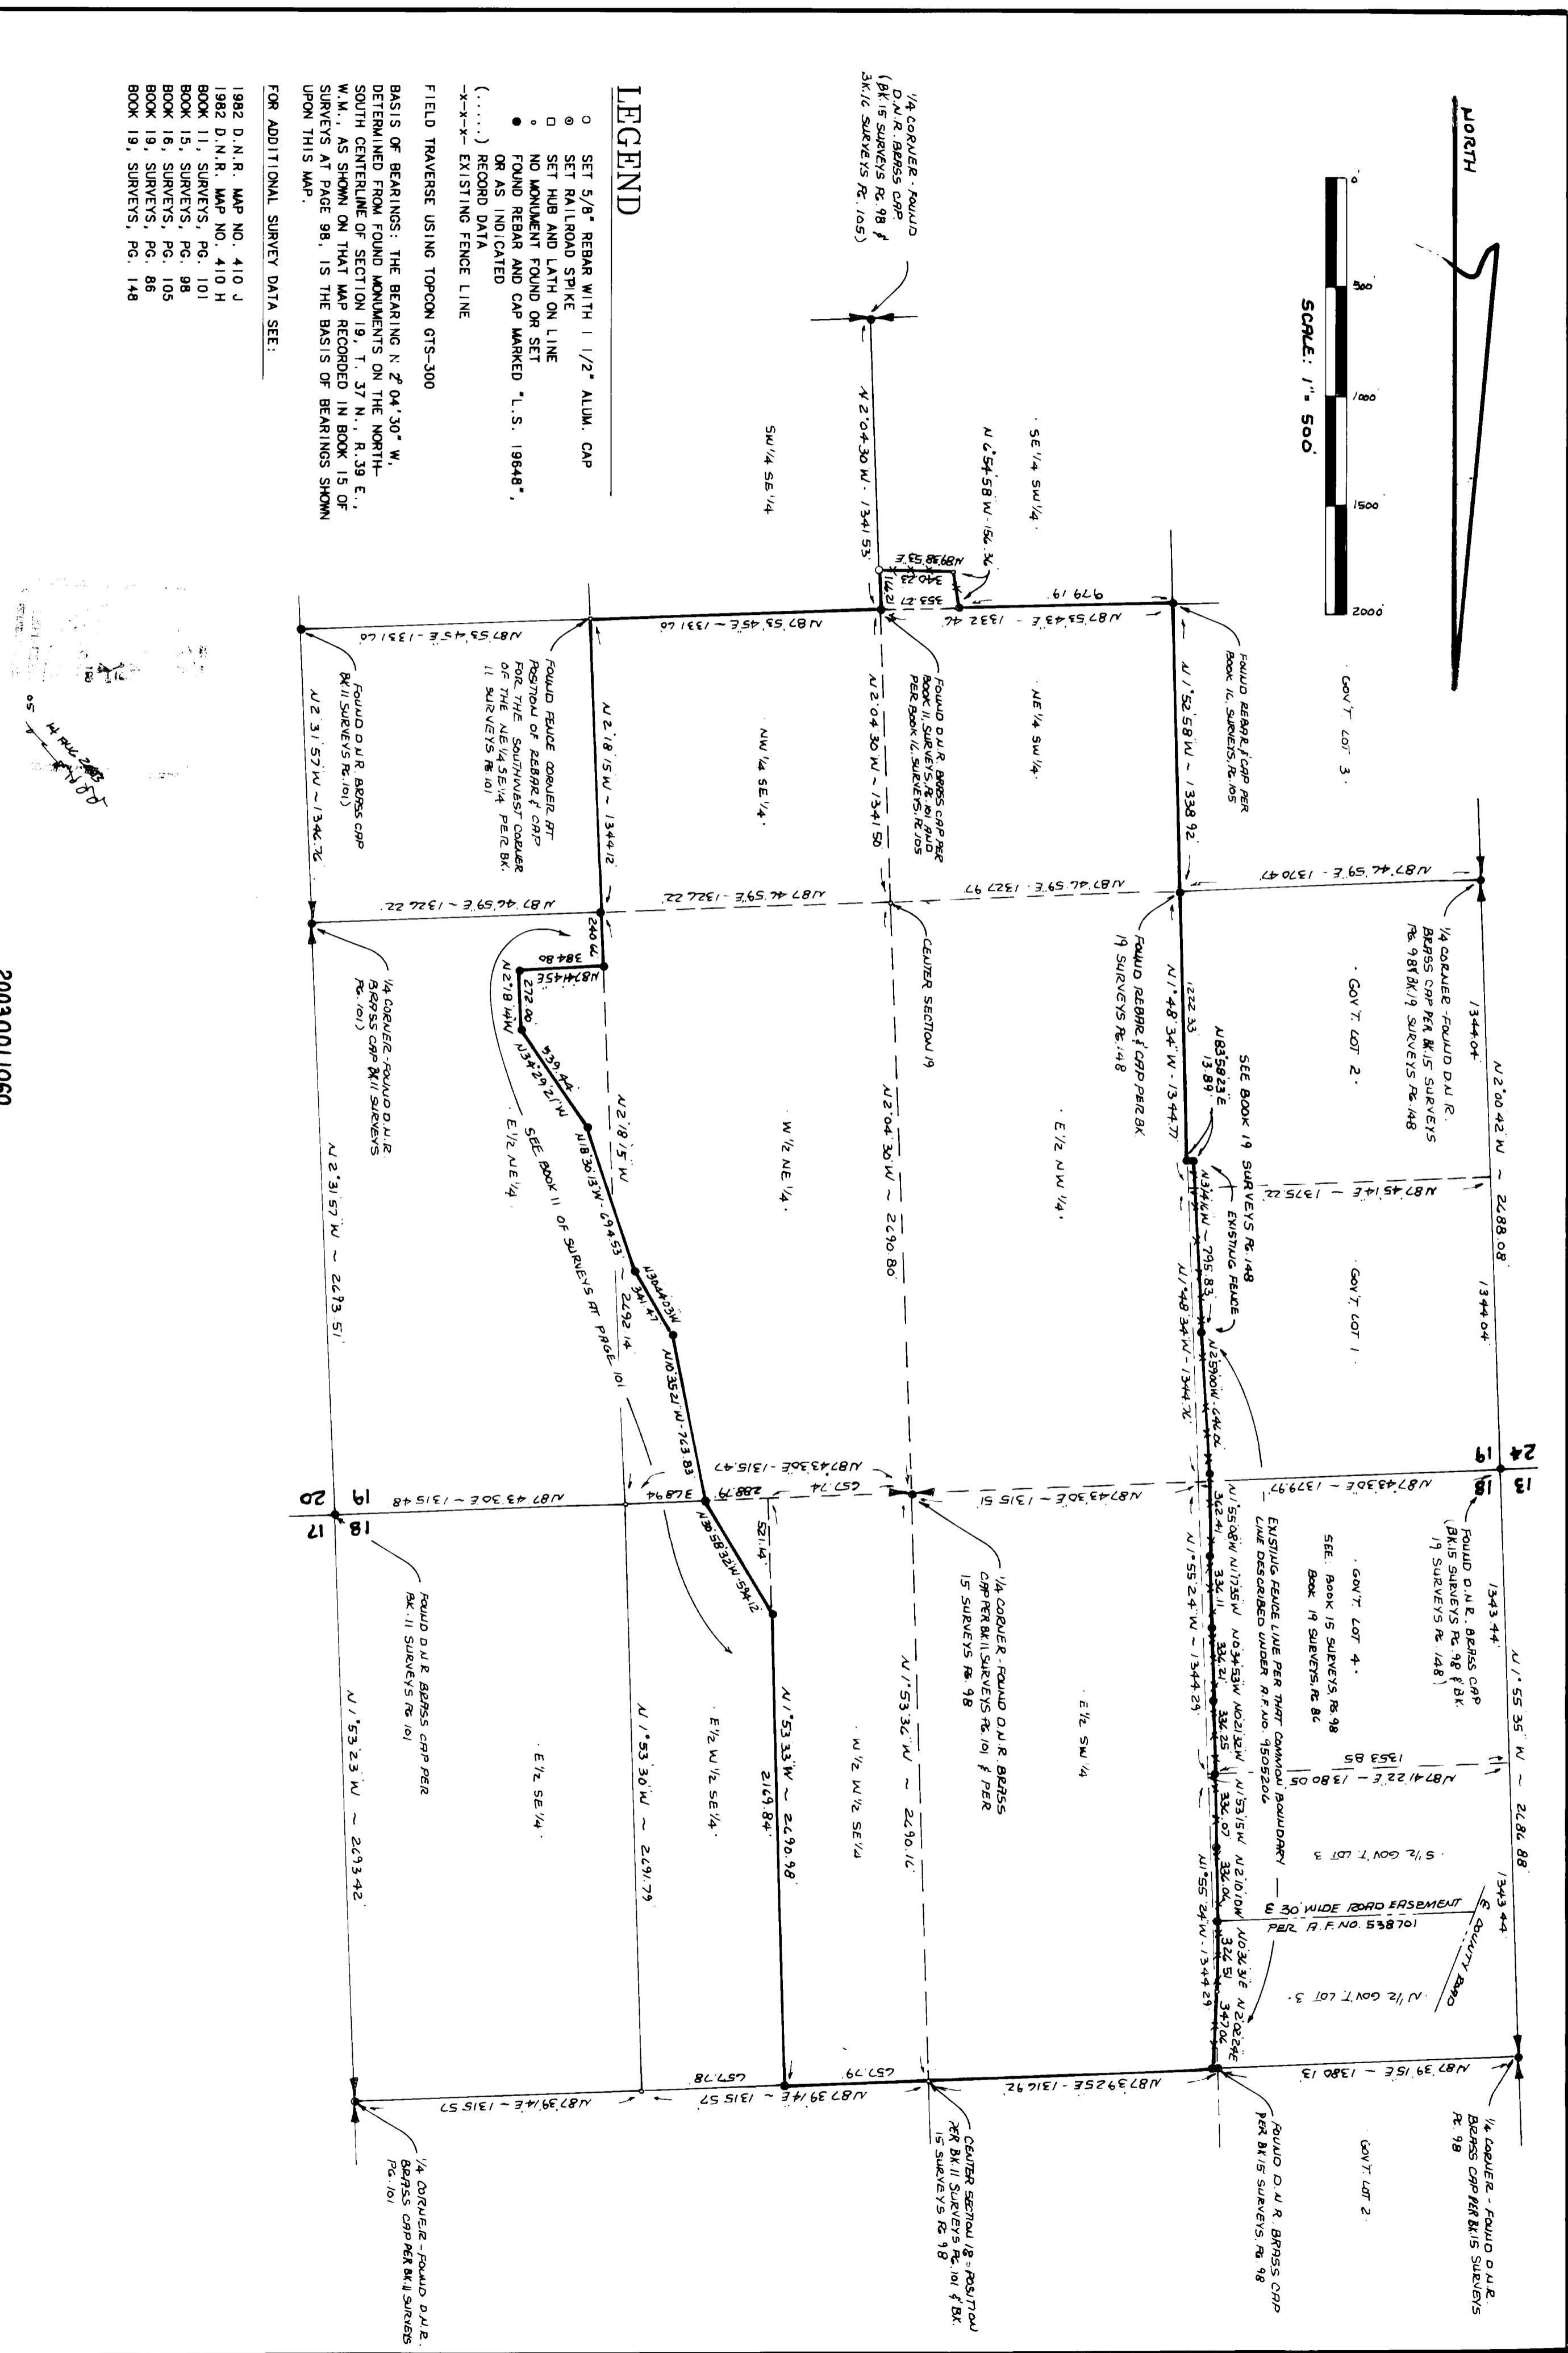

SURVEYOR'S CERTIFICATE

THIS MAP CORRECTLY REPRESENTS A SURVEY MADE BY ME OR
UNDER MY DIRECTION IN CONFORMANCE WITH THE REQUIREMENTS
OF THE SURVEY RECORDING ACT AT THE REQUEST OF _____
EUGENE R. SPRUNG
IN IOWA - AUG. 2003.

THOMAS E. TODD, L.S. 19648
455 SOUTH OAK STREET
COLVILLE, WASHINGTON 99114
(509) 684-8661

ADDITONAL CER-

AUDITOR'S CERTIFICATE

FILED FOR RECORD THIS 14th DAY OF August, 2003
IN BOOK 3 OF SURVEYS - 100

AT THE REQUEST OF THOMAS E. HODD,
Tim Gray _____ DEPUTY AUDITOR
COUNTY AUDITOR F. Clinton

CS 2.00
DNR 46.00
S&F 2.00
LTH 9.50

161297 page 3335

RECORD OF SURVEY

IN THE W 1/2 SE 1/4, IN THE E 1/2 SW 1/4, AND IN GOVERNMENT LOTS 3 AND 4, ALL IN SECTION 18, T. 37 N., R. 39 E., W.M., AND IN THE NE 1/4, IN THE NW 1/4 SE 1/4, IN THE E 1/2 NW 1/4, IN THE E 1/2 SW 1/4, AND IN GOVERNMENT LOTS 1 AND 2, ALL IN SECTION 19, T. 37 N., R. 39 E., W.M., STEVENS COUNTY, WASHINGTON.

SHEET 1 OF 6 SHEETS

GOVT. LOT 1.

GOVT. LOT 2.

GOVT. LOT 3.

GOVT. LOT 4.

SECTION 18 (SEE BOOK 15 OF SURVEYS AT PAGE 98)

SECTION 19





RECORD OF SURVEY

IN THE W 1/2 SE 1/4, IN THE E 1/2 SW 1/4, AND IN GOVERNMENT LOT 3 AND 4, ALL IN SECTION 18, T. 37 N., R. 39 E., W.M., AND IN THE NE 1/4, IN THE NW 1/4 SE 1/4, IN THE E 1/2 NW 1/4, IN THE E 1/2 SW 1/4, AND IN GOVERNMENT LOTS 1 AND 2, ALL IN SECTION 19 T. 37 N., R. 39 E., W.M., STEVENS COUNTY, WASHINGTON.

THOMAS E. TODD, L.S. | 9648
455 SOUTH OAK STREET
COLVILLE, WASHINGTON 99114
(509) 684-8661

2003011060

IN THE W 1/2 SE 1/4, IN THE E 1/2 SW 1/4, AND IN GOVERNMENT LOT 3 AND 4, ALL IN SECTION 18, T. 37 N., R. 39 E., W.M., AND IN THE NE 1/4, IN THE NW 1/4 SE 1/4, IN THE E 1/2 NW 1/4, IN THE E 1/2 SW 1/4, AND IN GOVERNMENT LOTS 1 AND 2, ALL IN SECTION 19 T. 37 N., R. 39 E., W.M., STEVENS COUNTY, WASHINGTON.

SCALE: 1" = 300'

A hand-drawn diagram consisting of a vertical line and a horizontal line segment. The vertical line has a horizontal segment extending from its middle. The word "NORTH" is written vertically along the left side of the vertical line.

