


FOR SALE



SOLD

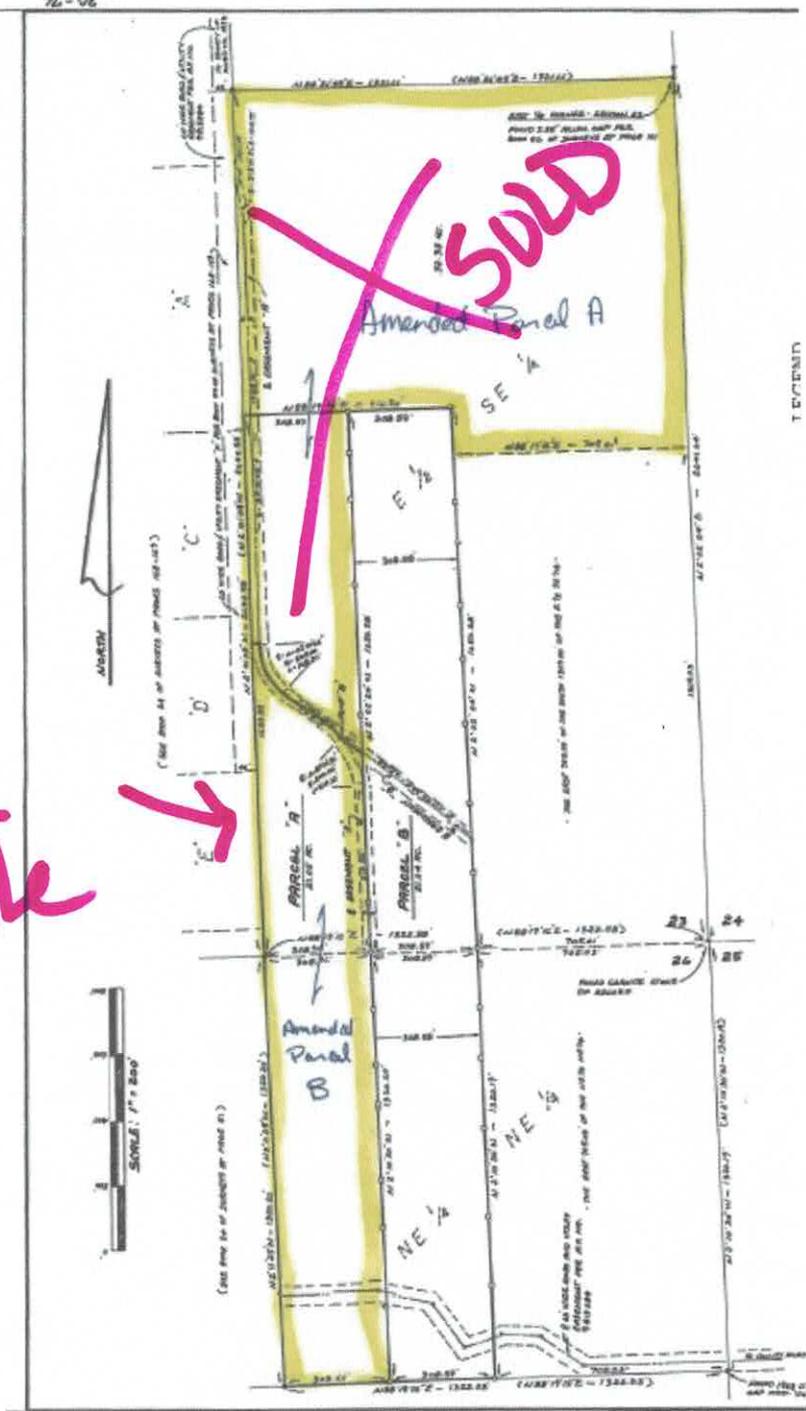

TERRAIN