

WATER WELL REPORT

Notice of Intent W134771

Date Printed 24-May-2001

Unique Well ID No AFF334

Log No 0

State of Washington

Water Right Permit Number

(1) OWNER HUMPHREY, NICK Address 3305 BRADEEN RD Rice, WA 99167
(2) LOCATION OF WELL County STEVENS NE 1/4 SE 1/4 Sec 34 T 33 R 37E WM
(2a) Street Address of well
Tax Parcel No

(3) PROPOSED USE DOMESTIC

(4) TYPE OF WORK Owners' Number of well
DEEPEMED (If more than one well) 1

Date 05/24/2001 Method ROTARY

(5) DIMENSIONS Diameter of well 6 inches
Drilled 200 ft Depth of completed well 640 ft

(6) CONSTRUCTION DETAILS Casing installed EXISTING

Liner installed " Dia from ft to ft
" Dia from ft to ft
Dia from ft to ft " Dia from ft to ft

Perforations used? No Used In

Type of perforator used

SIZE of perforations in by in

Perforations from ft to ft

Perforations from ft to ft

Perforations from ft to ft

Screens No K-Pac Location

Manufacture's Name

Type Model No

Diam slot size from ft to ft

Diam slot size from ft to ft

Gravel packed No Size of Gravel

Gravel placed from ft to ft

Surface seal No To what depth ft

Seal method Material used in seal EXISTING

Did any strata contain unusable water? No

Type of water Depth of strata

Method of sealing strata off

(7) PUMP Manufacture's name

Type H P 0

(8) WATER LEVELS Land-surface elevation
above mean sea level 0 ft

Static level 200 ft below top of well Date 05/16/2001

Artesian Pressure lbs per square inch Date

Artesian water controlled by

(9) WELL TEST Drawdown is amount water level is lowered below static
level

Was a pump test made? No If yes by whom

Yield gal/min with ft drawdown after

Recovery data Test Date

Time Water Level Time Water Level Time Water Level

Bailer test gal/min ft drawdown after hrs

Air test 8 gal/min w/ stern set at 639 ft for 1 hours


Artesian flow gpm Date

Temperature of water Was a chemical analysis made No

(10) Well Log

Formation Describe by color, character, size of material and
structure Show thickness of aquifers and the kind and nature of the
material in each stratum penetrated Show at least one entry for each
change in formation

Material	From	To
EXISTING WELL	0	140
GRAY LIMESTONE SOFT	440	451
GRAY LIMESTONE FRACTURED MOIST	462	470
GRAY LIMESTONE MEDIUM WWATER	470	520
GRAY LIMESTONE MEDIUM	520	618
DARK GRAY LIMESTONE FRACTURED	618	622
WATERBEARING	622	622
GRAY LIMESTONE MEDIUM	622	630

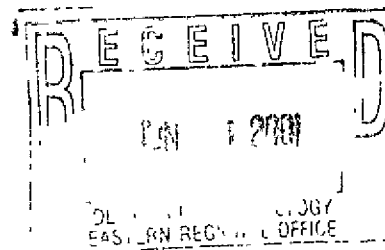

Notes

CUSTOMER REFUSED LINER

Work started 05/15/2001

Completed 05/16/2001

WELL CONSTRUCTION CERTIFICATION

I constructed and/or accept responsibility for construction of this well and its compliance with
Washington well construction standards. Materials used and the information reported are
to my best knowledge and belief.

RON HURN

License No 2258

(Driller/Licensed Engineer)

Trainee Name

License No

NAME FOGLE PUMP & SUPPLY INC

Shop COLVILLE

ADDRESS 316 W 5TH

Colville, WA 99114

Phone 509-684-2569

Toll Free 800-533-6518

E-Mail

FAX 509-684-3032

WEB Site www.foglepump.com

[SIGNED] Ron Hurn/RH

License No 2258

(Driller/Licensed Engineer)

Contractor's

Registration No

FOGLEPS095L4

Date Log Created 5/24/01