
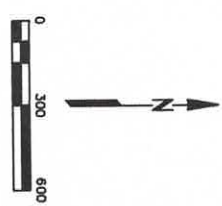



# RECORD OF SURVEY

PORTION OF THE NE 1/4 OF THE SE 1/4, THE NW 1/4 OF THE SE 1/4, THE SW 1/4 OF THE SE 1/4, THE SE 1/4 OF THE SE 1/4 OF SECTION 19, TOWNSHIP 30 NORTH, RANGE 41 EAST, W.M., STEVENS COUNTY, WASHINGTON, SEPTEMBER 2025  
PAGE 1 OF 2

SECTION 19, T30N, R41E

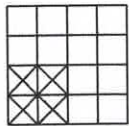

- LEGEND**
- PROPERTY LINE
  - ADJACENT PROPERTY
  - EXISTING EASEMENT
  - FOUND 2" ALUMINUM CAP MARKED "SAMSON 38627" OR AS NOTED PER RI
  - SET 1/2" BEAM W/CAP
  - SCHEMATIC PLS 57448
  - FOUND SECTION CORNER AS NOTED
  - FOUND QUARTER SECTION CORNER AS NOTED
  - RECORD MEASUREMENT
  - EXCEPTION #

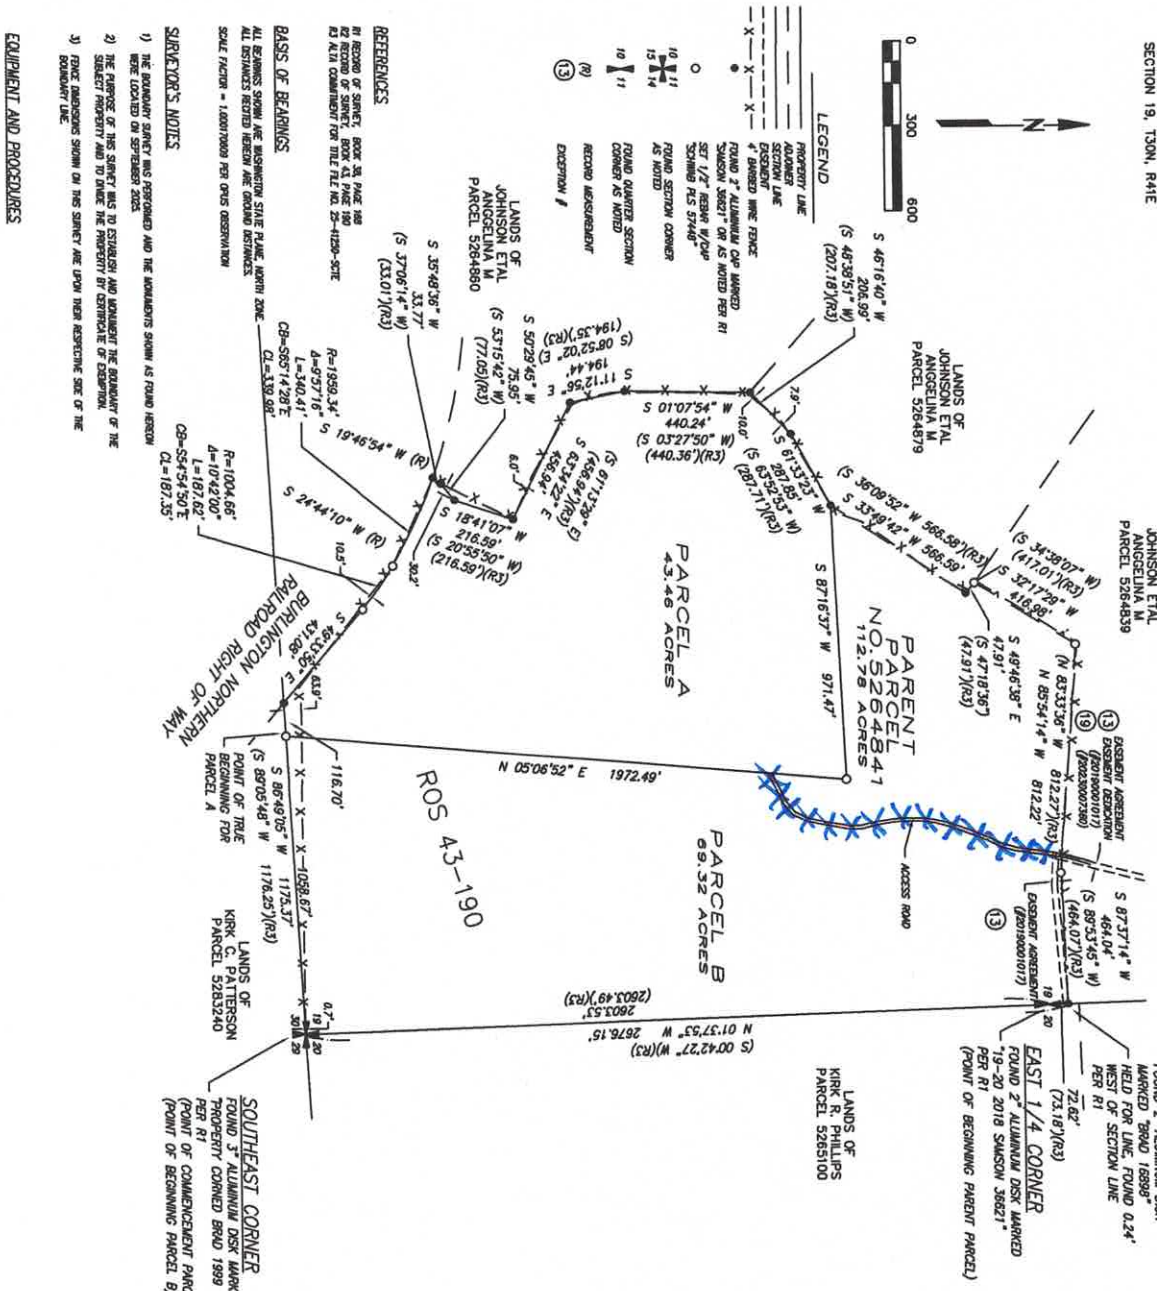

**AUDITORS CERTIFICATE**  
FIELD FOR RECORD THE DATE OF \_\_\_\_\_ AT PAGE 20  
AT THE REQUEST OF \_\_\_\_\_

STEVENS COUNTY AUDITOR OR DEPUTY

**STEVENS COUNTY TITLE & ESOROW**  
COMMITMENT NO. 25-41250-SCIE  
SCHEDULE B - EXCEPTIONS:

- 13) EASEMENT AGREEMENT, RECORDED FEBRUARY 19, 2016, RECORRING NO. 20160010171, AFFECTS SUBJECT PROPERTY, NOT PLOTTED.
- 14) RECORD OF SURVEY, RECORDED JUNE 18, 2021, RECORRING NO. 20210001266, AFFECTS SUBJECT PROPERTY, NOT PLOTTED, GENERAL NATURE.
- 15) RECORD OF SURVEY, RECORDED FEBRUARY 14, 2022, RECORRING NO. 20220001416, DOES NOT AFFECT SUBJECT PROPERTY, NOT PLOTTED.
- 16) CERTIFICATE OF EASEMENT, RECORDED NOVEMBER 9, 2023, RECORRING NO. 20230000946, AFFECTS SUBJECT PROPERTY, NOT PLOTTED, GENERAL NATURE.
- 17) RECORD OF SURVEY, RECORDED NOVEMBER 21, 2023, RECORRING NO. 20230001671, AFFECTS SUBJECT PROPERTY, NOT PLOTTED, GENERAL NATURE.
- 18) RECORD OF SURVEY, RECORDED NOVEMBER 21, 2023, RECORRING NO. 20230001666, AFFECTS SUBJECT PROPERTY, NOT PLOTTED, GENERAL NATURE.
- 19) EASEMENT DEDICATION, RECORDED NOVEMBER 30, 2023, RECORRING NO. 20230001706, AFFECTS SUBJECT PROPERTY, NOT PLOTTED.

**SURVEYOR'S CERTIFICATE**  
THIS MAP CORRECTLY REPRESENTS A SURVEY MADE BY ME OR UNDER MY DIRECTION IN COMPLIANCE WITH THE REQUIREMENTS OF THE SURVEY REGULATION ACT AT THE REQUEST OF THOMAS SWANSON IN SEPTEMBER, 2025.

**PRELIMINARY**  
DATE: 09/15/2025  
BY: [Signature]

**Ultra LAND SURVEYING**  
P.O. Box 1254, Mead, Washington 99021  
(408) 544-6718 www.ultrasurveying.com

**RECORD OF SURVEY**  
LANDS OF: THOMAS SWANSON  
ADDRESS: NO ASSIGNED ADDRESS  
PARCEL NO. 5264841  
DRAWN BY: ALH  
CHECKED BY: CCS  
SHEET OF 2  
SURVEY DATE: 09/15/2025  
JOB NO. 25-045

SCALE: 1 INCH = 300 FT.  
REVISIONS:

**EQUIPMENT AND PROCEDURES**


**REFERENCES**


**BASIS OF BEARINGS**


**SURVEYOR'S NOTES**

- 1) THE BOUNDARY SURVEY WAS PERFORMED AND THE MONUMENTS SHOWN AS FOUND HEREON WERE LOCATED ON SEPTEMBER 2025.
- 3) FENCE MONUMENTS SHOWN ON THIS SURVEY ARE UPON THEIR RESPECTIVE SIDE OF THE BOUNDARY LINE.