

WATER WELL REPORT

State of Washington Date Printed: 15-Apr-2010 Log No. 0
 Construction / Decommission: Original Construction
 Construction Notice of Intent #: 392114

CURRENT

Notice of Intent No.: WE11185
 Unique Ecology Well I.D. No BBL604
 Water Right Permit Number:

OWNER: COFFEN, ROBERT & LUCINDA
 OWNER ADD 1723 MOUNTAIN GARDEN WAY
 KETTLE FALLS, WA 99141

Well Add: 822-J BARZEE ROAD

City: Colville, WA 99114 County: Stevens
 Location: SE 1/4 NE 1/4 Sec 17 T 34 R 39E EW
 Lat/Long: Lat Deg Lat Min/Sec
 (s, t, r still REQUIRED) Long Deg Long Min/Sec
 Tax Parcel No.: 2197410

PROPOSED USE: DOMESTIC	
TYPE OF WORK: Owners's Well Number: (If more than one well) NEW WELL Method: ROTARY	
DIMENSIONS: Diameter of well: 6 inches Drilled 200 ft. Depth of completed well 200 ft.	
CONSTRUCTION DETAILS:	Casing installed WELDED
Liner installed: PVC	6" Dia from +2 ft. to 64 ft.
4" Dia from 20 ft. to 200 ft.	" Dia from ft. to ft.
Perforations: Yes Used In: LINER	
Type of perforator used SKILL SAW	
SIZE of perforations 1/8 in. by 7 in.	
100 Perforations from 80 ft. to 200 ft.	
Perforations from ft. to ft.	
Perforations from ft. to ft.	
Screens: 0 K-Pac Location:	
Manufacture's Name	
Type:	Model No
Diam. slot size: from ft. to ft.	
Diam. slot size: from ft. to ft.	
Gravel/Filter packed: No Size of Gravel	
Material placed from ft. to ft.	
Surface seal: Yes To what depth 19 ft.	
Seal method: Material used in seal BENTONITE	
Did any strata contain unusable water No	
Type of water Depth of strata	
Method of sealing strata off	
PUMP: Manufacture's name	
Type: H.P. 0	
WATER LEVELS: Land-surface elevation above mean sea level: 0 ft.	
Static level 61 ft. below top of well Date 04/08/2010	
Artesian Pressure lbs per square inch Date	
Artesian water controlled by	

CONSTRUCTION OR DECOMMISSION PROCEDURE
 Formation: Describe by color, character, size of material and structure. Show thickness of aquifers and the kind and nature of the material in each stratum penetrated. Show at least one entry for each change in formation.

Material	From	To
HARD PAN CLAY W/GRAVEL	0	3
BLACK CLAY MOIST	30	3
DECOMPOSED GRANITE	34	6
SOFT BROWN GRANITE MOIST	64	1
FRACTURE W/WATER	147	1
GREY & BROWN GRANITE LAYERED MED	152	2

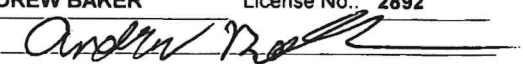

JUN 16 2010

Notes: DEPARTMENT OF ECOLOGY
 EASTERN REGIONAL OFFICE

Work started 04/08/2010 Complete 04/08/2010

WELL CONSTRUCTION CERTIFICATION:
 I constructed and/or accept responsibility for construction of this well and its compliance with all Washington well construction standards. Materials used and the information reported are true to my best knowledge and belief.

Driller Engineer Trainee

Name: **ANDREW BAKER** License No.: 2892
 Signature: 

If trainee, Licensed driller is: _____ License No.: _____
 Licensed Driller Signature _____

Drilling Company:
 NAME: **FOGLE PUMP & SUPPLY, INC.** Shop: **COLVILLE**
 ADDRESS: **316 W. 5TH**
 Colville, WA 99114
 Phone: **509-684-2569** Toll Free: **800-533-6518**
 E-Mail: **jeanne@foglepump.com**
 FAX: **509-684-3032** WEB Site: **www.foglepump.com**

WELL TESTS: Drawdown is amount water level is lowered below static level.

Was a pump test made? No If yes, by whom

Yield: gal/min with ft drawdown after

Yield: gal/min with ft drawdown after

Yield: gal/min with ft drawdown after

Recovery data (time taken as zero when pump turned off)(water level measured from well top to water level)

Time:	Water Level	Time:	Water Level	Time:	Water Level
<input type="text"/>	<input type="text"/>	<input type="text"/>	<input type="text"/>	<input type="text"/>	<input type="text"/>
<input type="text"/>	<input type="text"/>	<input type="text"/>	<input type="text"/>	<input type="text"/>	<input type="text"/>
<input type="text"/>	<input type="text"/>	<input type="text"/>	<input type="text"/>	<input type="text"/>	<input type="text"/>

Date of test:

Bailer test gal/min ft drawdown after hrs.

Air test 12 gal/min w/ stem set at 200 ft. for 1 hours

Artesian flow gpm Date

Temperature of water Was a chemical analysis made No

Contractor's
 Registration No.: **FOGLEPS095L4** Date Log Created: **4/15/2010**