


AL SAPP
150 Airport Rd
OMAK

N

S.E. corner

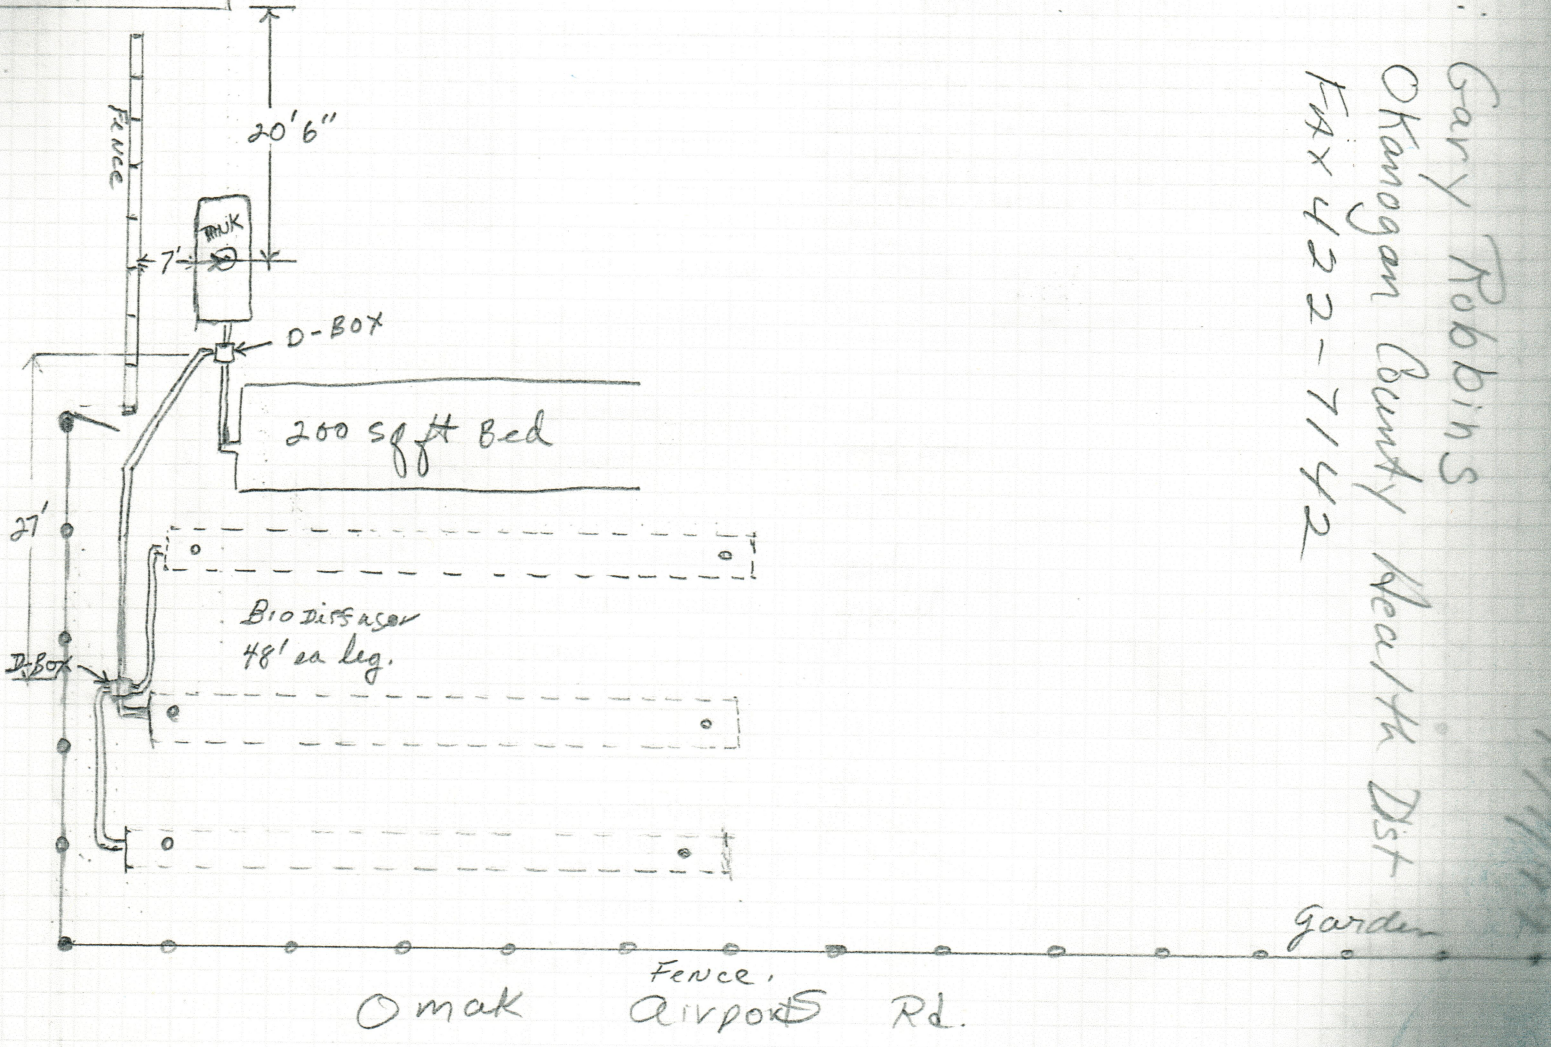

To: Gary Robbins
Okanogan County Health Dist
Fax 422-7142