
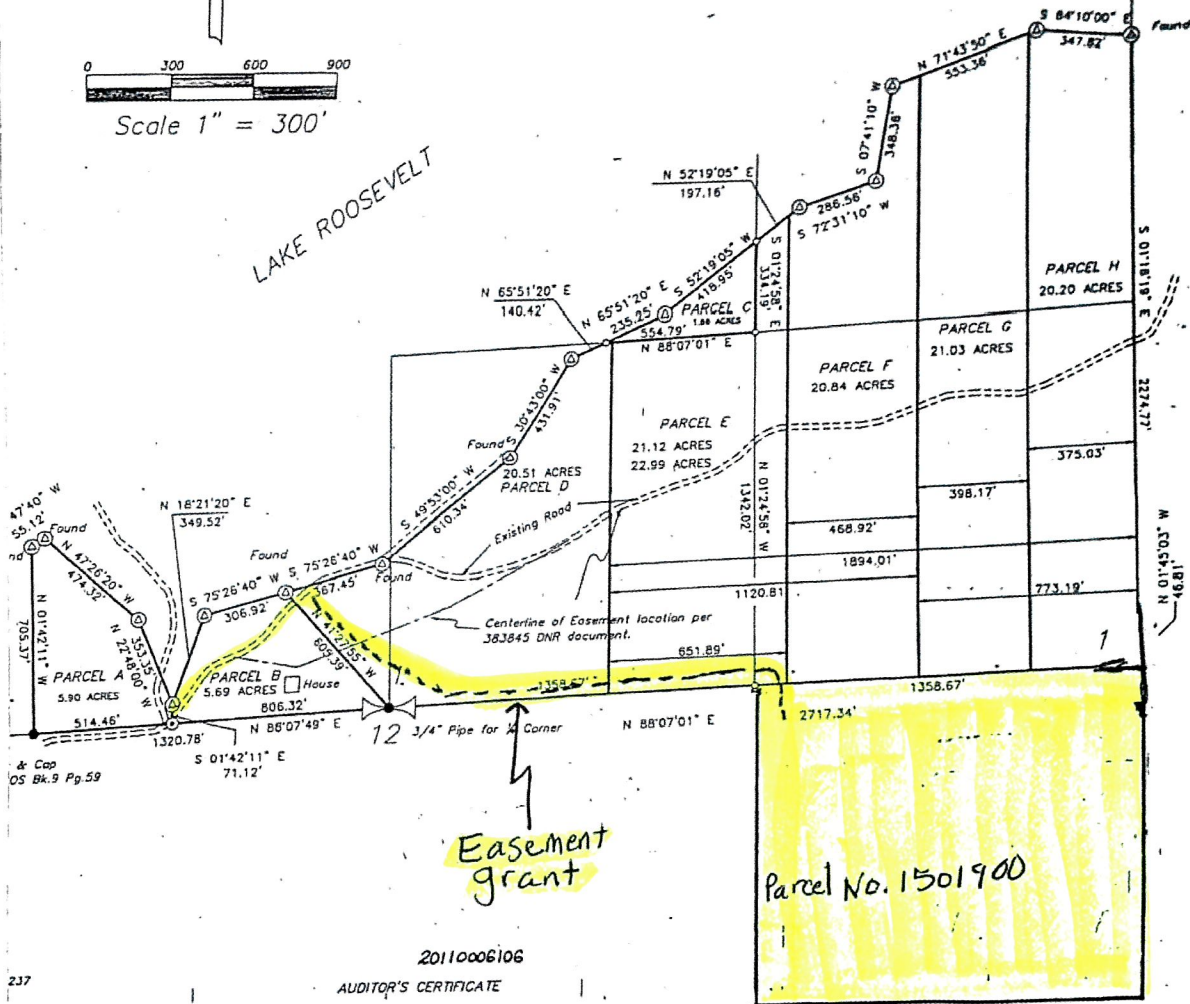


Exhibit A to Dedication of Mutual Easement Rights

Record of Survey

In the SW $\frac{1}{4}$ & SE $\frac{1}{4}$ of Section 1
T.29N., R.35E. W.M.
STEVENS COUNTY, WA.

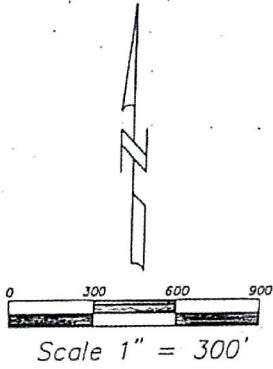

Easement grant

Parcel No. 1501900

20110006106

AUDITOR'S CERTIFICATE

237

(Not to scale, for illustrative purposes only)