SE W.M. SECTION 32, SW 1/4 OF THE NW 1/4,
2 MINTERS ADDITION TO MARCUS, PORTION
MBERLAIN SUBDIVISION, STEVENS COUNTY WA
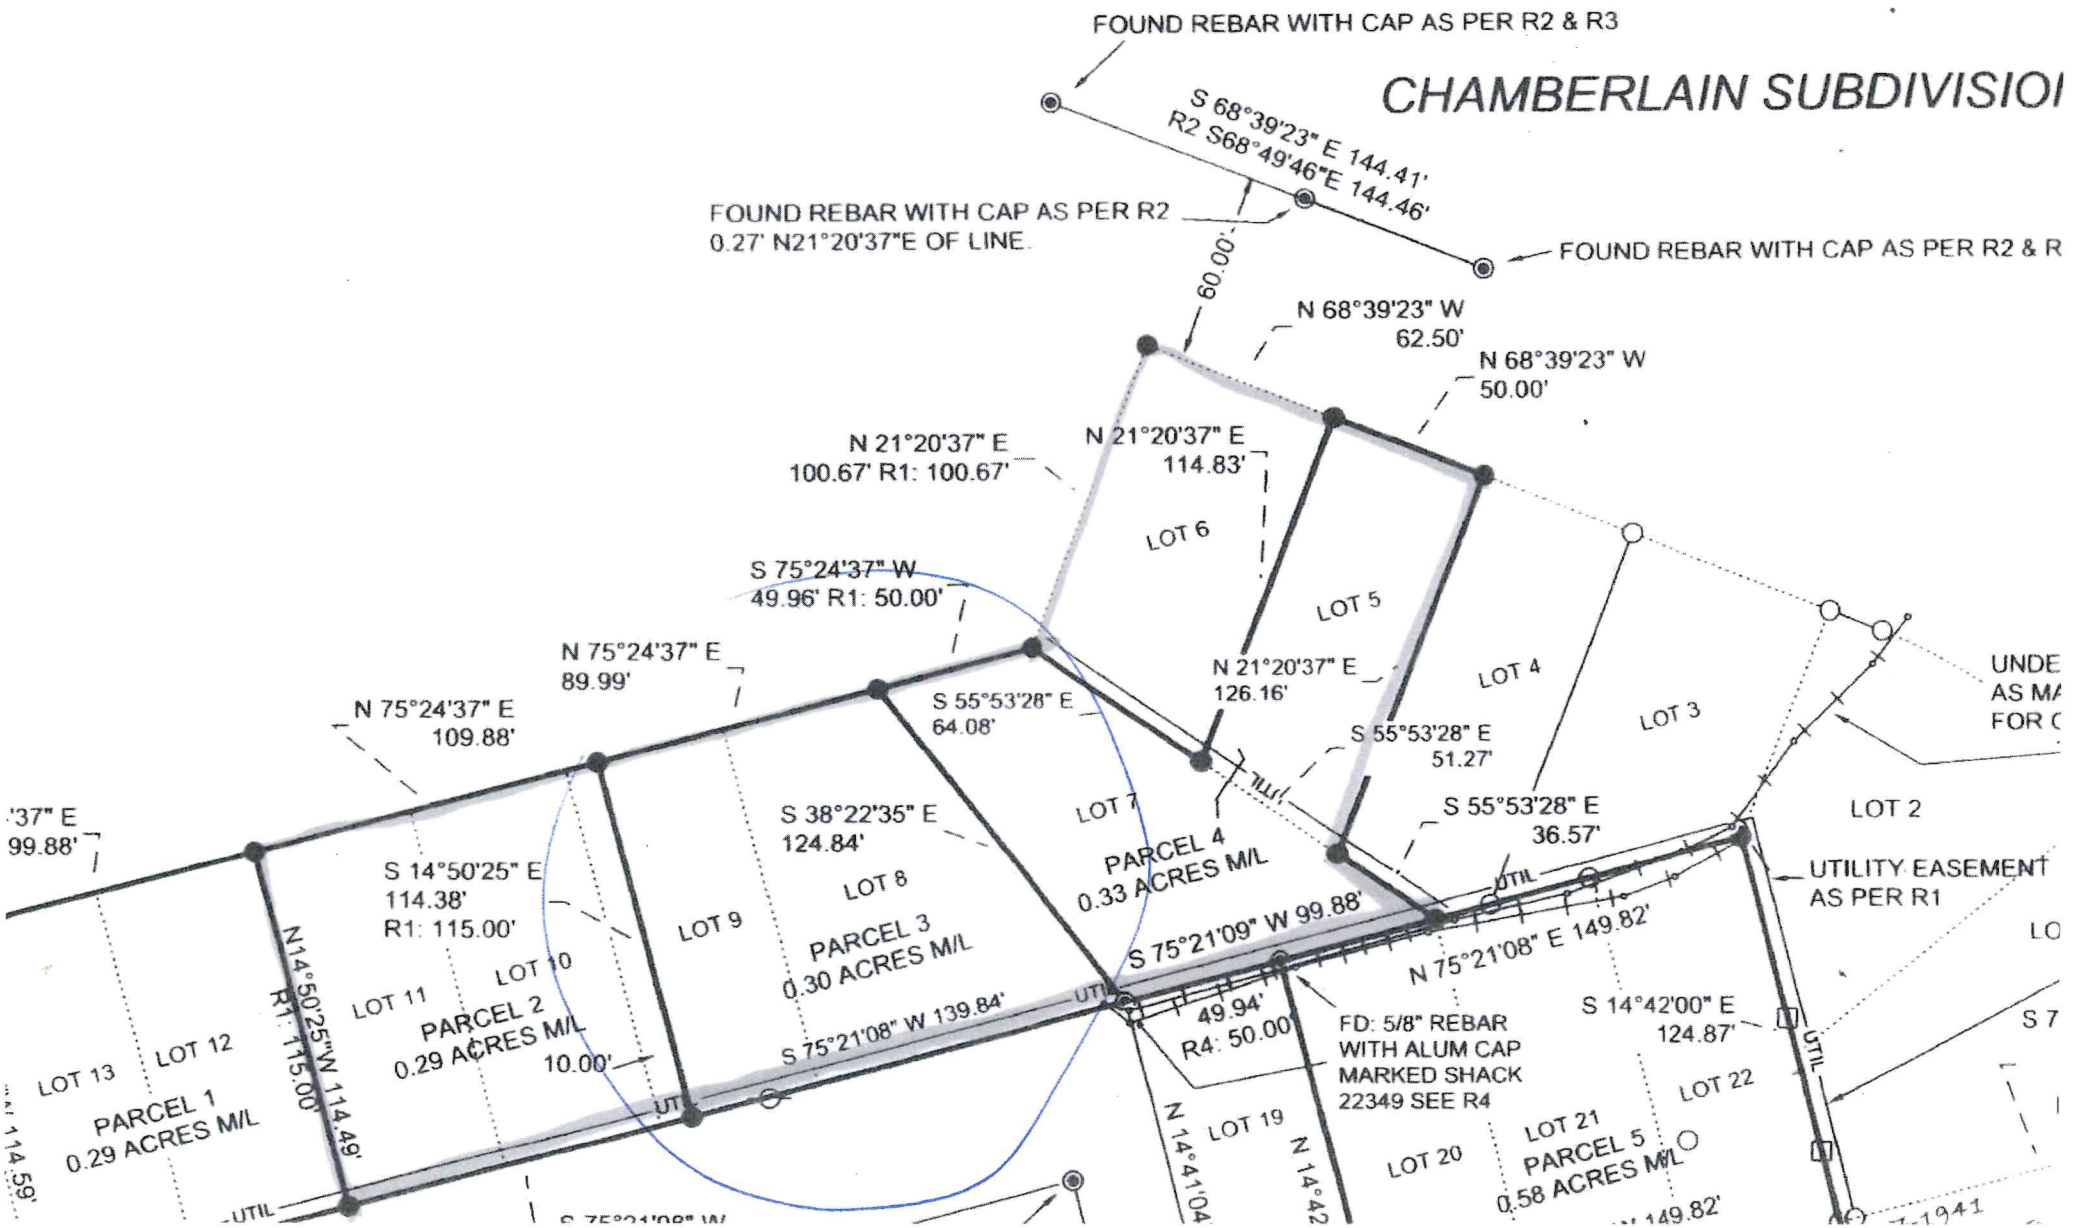
32-37-38