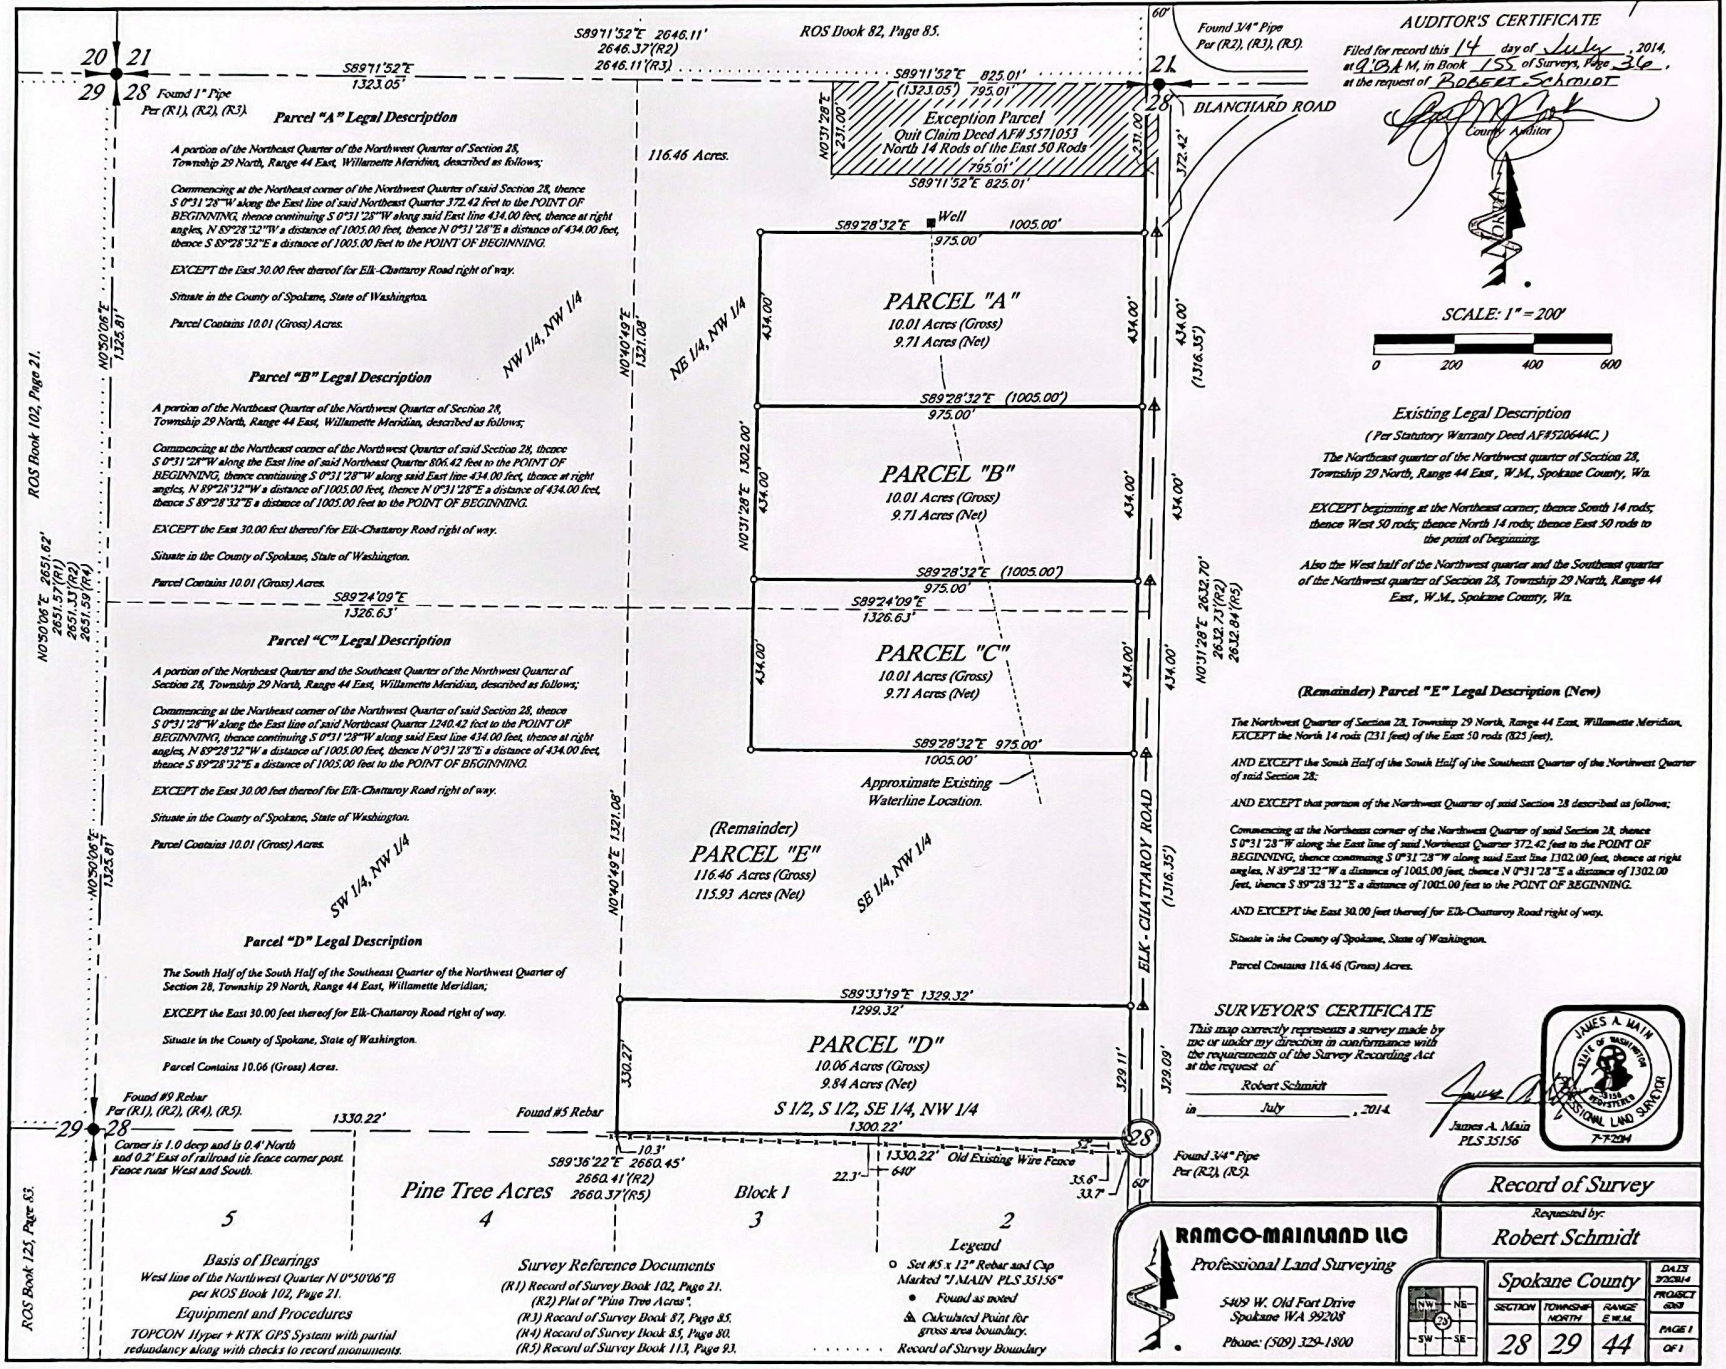6318104 155/36