


EVERT K. CLARK SEGREGATION SURVEY

N1/2 SE1/4 and a portion of the S1/2 S1/2 NE1/4 of Section 26,
T. 34 N., R. 36 E., W.M., FERRY COUNTY, WASHINGTON

SHEET 1 of 2

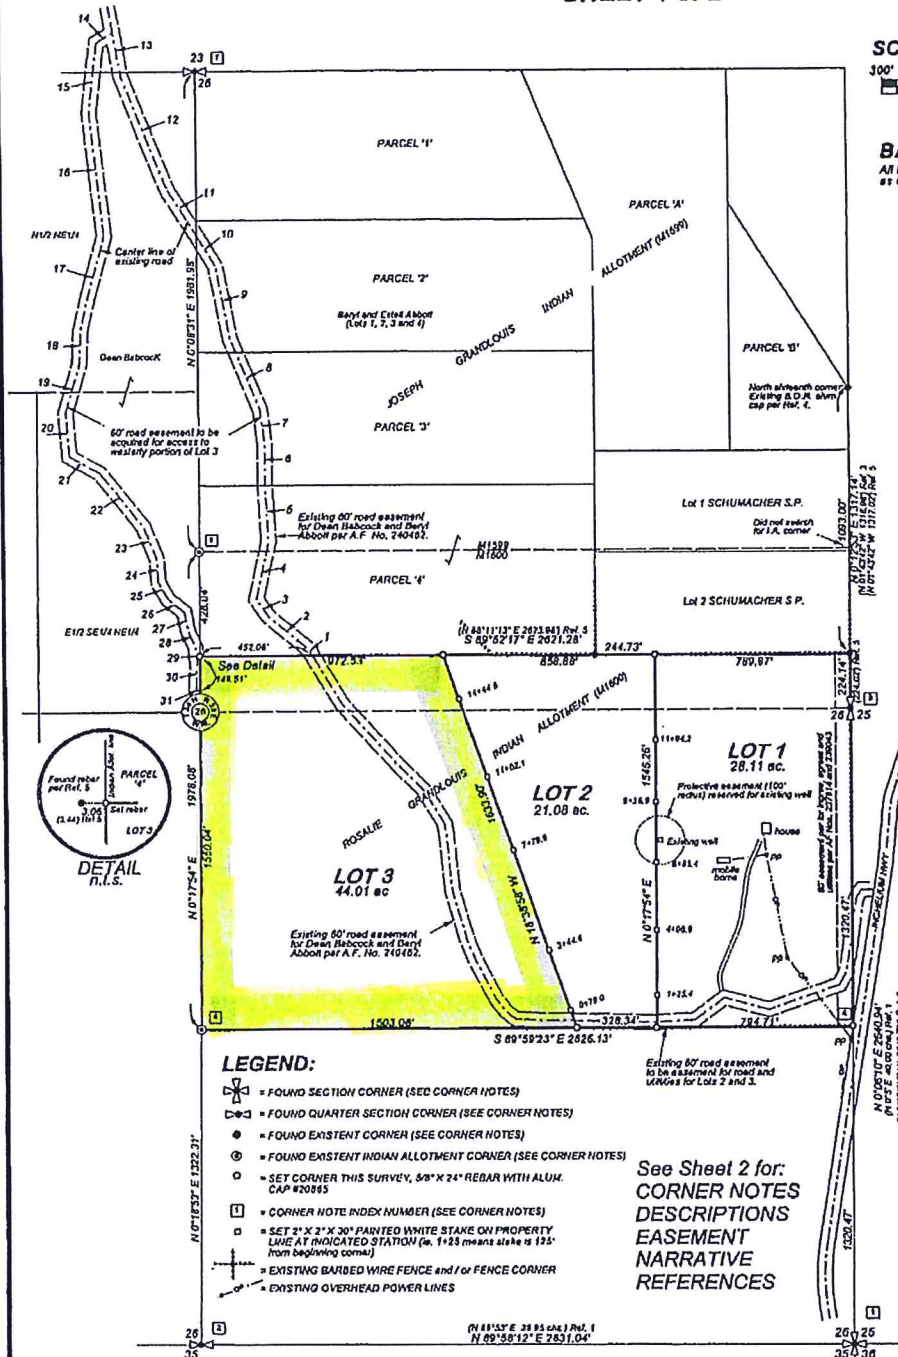

SCALE: 1 INCH = 300 FEET



BASIS OF BEARING:

All bearings are based on true meridian as determined by static GPS

ROAD EASEMENT CENTER LINE

1	N 50° 10' 18" W 33.22'
2	N 49° 34' 50" W 204.68'
3	N 34° 10' 43" W 84.71'
4	N 12° 11' 47" E 243.37'
5	N 3° 00' 54" W 250.21'
6	N 0° 28' 48" E 181.32'
7	N 7° 04' 41" W 138.44'
8	N 22° 15' 50" W 312.72'
9	N 10° 22' 34" W 208.43'
10	N 30° 15' 08" W 138.48'
11	N 32° 03' 41" W 230.27'
12	N 21° 14' 18" W 505.67'
13	N 10° 02' 44" W 182.37'
14	S 54° 10' 34" W 16.37'
15	S 6° 39' 34" W 289.89'
16	S 6° 16' 18" E 410.40'
17	S 14° 28' 18" W 407.13'
18	S 2° 20' 13" W 138.09'
19	N 6° 21' 20" W 203.02'
20	S 4° 10' 24" E 180.28'
21	S 60° 43' 14" E 140.28'
22	S 3° 27' 02" E 288.37'
23	S 21° 40' 43" E 140.34'
24	S 3° 20' 48" E 101.51'
25	S 30° 18' 27" E 89.78'
26	S 81° 12' 26" E 61.31'
27	S 10° 14' 10" E 74.06'
28	S 23° 54' 54" E 75.88'
29	S 33° 10' E 70.84'
30	S 31° 40' W 103.12'
31	S 45° 44' 54" E 21.64'

Section 26
T 34 N, R 36 E, W.M.



SURVEYOR'S CERTIFICATE

This map correctly represents a survey performed by me, or under my direction, and in accordance with the Survey Recording Act.

At the request of: Evert Clark
in October of 2003.

Signed and sealed this 22nd day of Apr, 2004.

Grant D. Tolton, P.L.S. Certificate no. 20865

AUDITOR'S CERTIFICATE


Filed for record this 22nd day of April, 2004

at 2:30 P.M., page 169, book 4 of Surveys.

At the request of: Evert Clark

AUDITOR'S FILE NO. 255901

Deanne Bohinger, Deputy
County Auditor, Ferry County Auditor

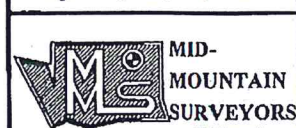

Grant D. Tolton
Professional Land Surveyor

1144 Mountain Lane
Republic, WA 99166
(509) 733-3343
midmountainsurveyors.com

FILENAME:
C:\A\JOBS 2003\EVERT CLARK DRAWING\CLARK ROS.DWG

DRAWN BY: EGF, & G.D.T. DATE: 4-21-04

CHECKED BY: G.D.T. JOB NO.: 03-011

SCALE: 1" = 300' SHEET 1 OF 2