


Stevens County Parcel Map

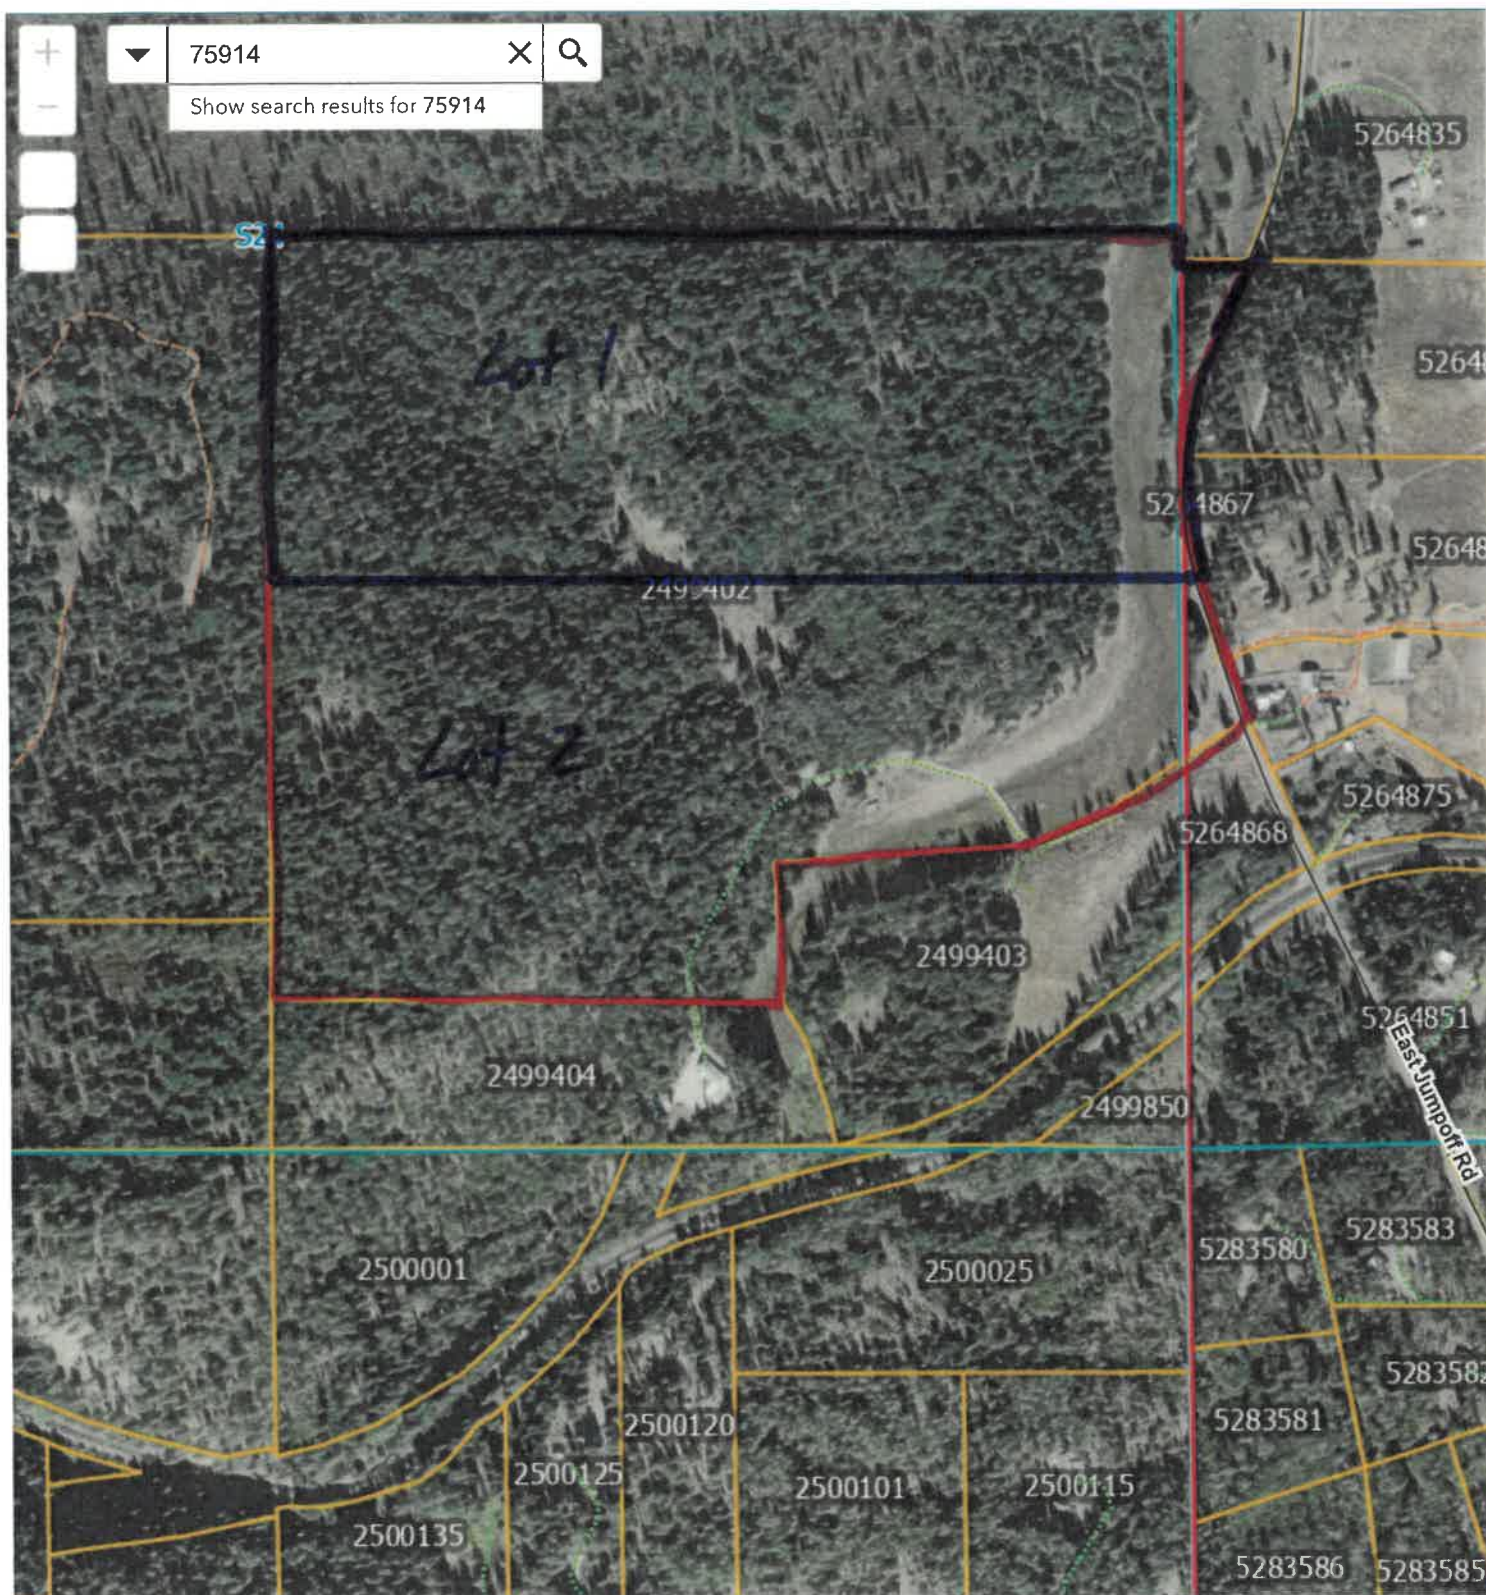

600ft