
TRUS JOIST MacMILLAN
A Limited Partnership

Silent Floor JOISTS

East & West Boundary Lines Equal Length = 226' +
North & South Boundary Lines Equal Length = 495'
Hwy Right of way To ℄ = 50'

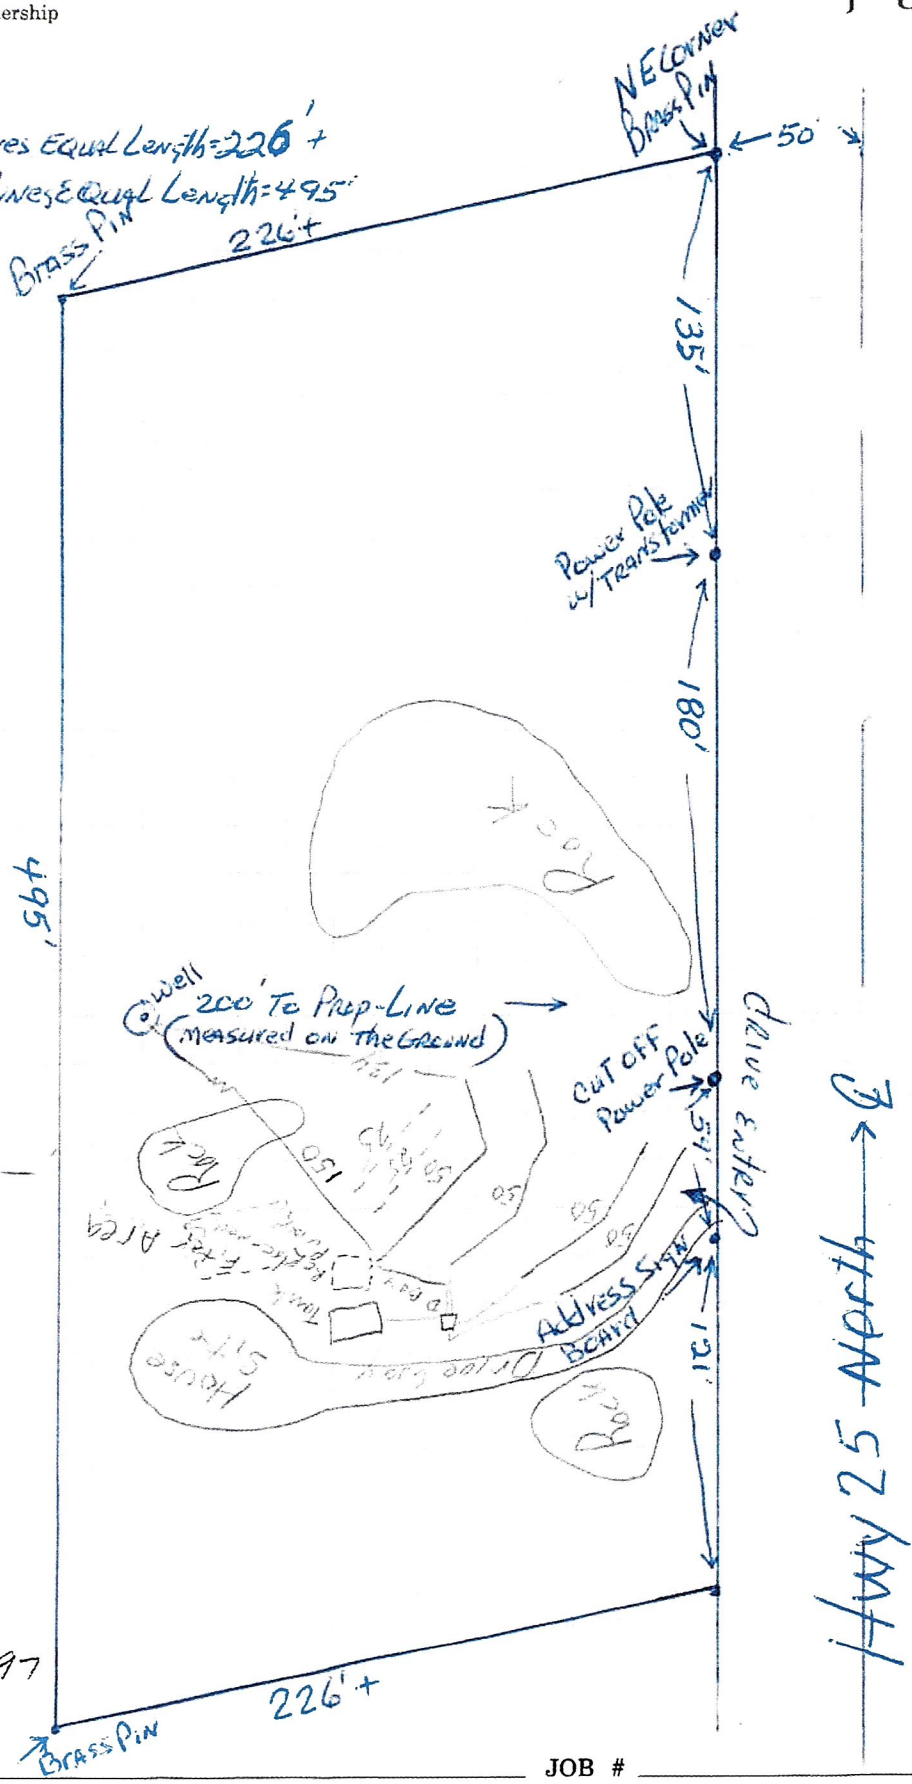

RECEIVED
JUN 06 1997
ENV. HEALTH - COLVILLE

James Ellis

Jim Mallery 6-6-97

JOB NAME: _____ JOB # _____

LOCATION: 1/4" EQUALS 16.5' Approx SHEET _____ OF _____

SALESMAN: _____ BY _____ DATE: _____