36-37-32
Lot 234 Gold Mnt. Ranches

NORTHEAST TRI COUNTY HEALTH DISTRICT
DIVISION OF ENVIRONMENTAL HEALTH

ON-SITE SEWAGE SYSTEM PERMIT #100005078

SR7325
ON 6851

Greg and Teri Perkins are hereby authorized to utilize a sewage disposal system at
Lot 234 A Gold Mountain Ranches
Section: 36 Township: 37 Range: 32 Parcel #2-37-36-50-02341-00

in accordance with the plans and specifications approved by the District Health officer on file in this office.

Prior to any major repairs, replacements or alterations to the system a permit shall be obtained from the Northeast Tri County Health District (Division of Environmental Health).

This permit is issued and may be revoked by the Northeast Tri County Health District Health Officer by authority of WAC 246-272, and Northeast Tri County Health District Regulations established by the Board of Health pursuant to RCW 70.05.

Additional permits from other jurisdictions or agencies may be necessary for this project. It is the responsibility of the applicant to acquire said permit(s), and comply with all applicable rules, regulations and/or ordinances.

District Health Officer

Date Permit Issued: July 26, 2005

PERMIT INSTRUCTIONS

STRUCTURE TYPE: Single Family Residence
NUMBER OF BEDROOMS: 3
DESIGN FLOW: 360 gal/day
TYPE OF SYSTEM: New
SYSTEM DESIGN: Conventional Gravity
SEPTIC TANK CAPACITY (gal): 1000
REASON SYSTEM DESIGN:

DFLF/BED DIMENSIONS: 300 ft
TRENCH DEPTH : 24 inches
TRENCH WIDTH : 36 inches
APPURTENANCES:
PUMP CHAMBER: no
PUMP CHAMBER GALLONS:

SPECIAL PERMIT INSTRUCTIONS:

FINAL INSPECTION DATE: 6/12/06

INITIALS: BH

**SEE REVERSE FOR AS BUILT DRAWING

*Stevens County Office	P.O. Box 270	Colville, WA 99114	(509)684-2262
*Pend Oreille County Office	P.O. Box 490	Newport, WA 99156	(509)447-3131
*Ferry County Office	P.O. Box 584	Republic, WA 99166	(509)775-3111

NORTHEAST TRI COUNTY HEALTH DISTRICT
AS-BUILT DRAWING - PERMIT # 10005078

INSPECTION DATE 6/12/06 INSPECTED BY BH APPROVED: ☑ YES ☐ NO

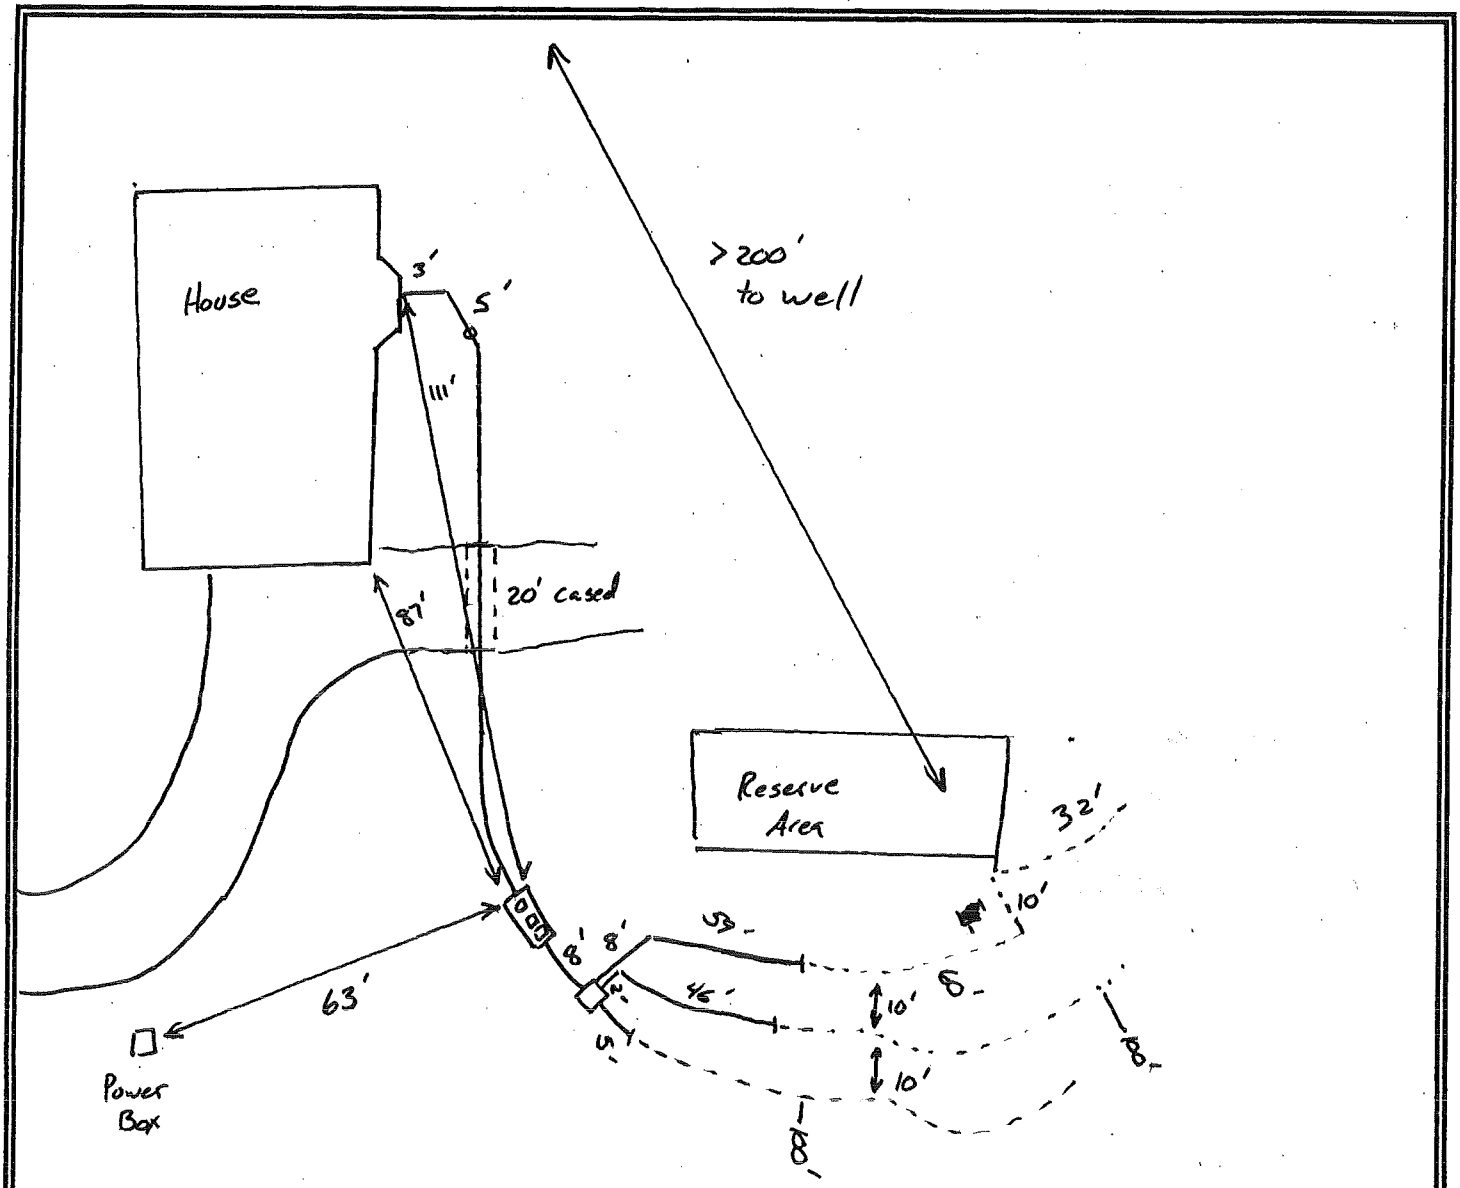

Installer Name Mike Fegley	Pump Chamber Size
Septic Tank Size 1000	Doses/Day Gallons/Dose
Drainfield Length 300'	Squirt Height Drawdown
Drainfield Depth 24"	Pump Run Time

(Revised 7/2003)