NORTHEAST TRI COUNTY HEALTH DISTRICT
DIVISION OF ENVIRONMENTAL HEALTH

ON-SITE SEWAGE SYSTEM PERMIT # PI0018725

Albert and Pauline Illes is hereby authorized to utilize a sewage disposal system at Hunter's Olson INc Vac St Block: 11 Lot: 21-23

Section: 7 **Township: 30** **Range: 37** **Parcel #: 0468800**

in accordance with the plans and specifications approved by the District Health Officer on file in this office.

Prior to any major repairs, replacements or alterations to the system a permit shall be obtained from the NorthEast Tri County Health District (Division of Environmental Health).

This permit is issued and may be revoked by the NorthEast Tri County Health District Health Officer by authority of WAC 246-272, and Northeast Tri County Health District Regulations established by the Board of Health pursuant to RCW 70.05.

Additional permits from other jurisdictions or agencies may be necessary for this project. It is the responsibility of the applicant to acquire said permit(s), and comply with all applicable rules, regulations and/or ordinances.

Date Issued: 10/09/2018

District Health Officer

PERMIT INSTRUCTIONS

STRUCTURE TYPE: Single-Family Residential

NUMBER OF BEDROOMS: 2

DESIGN FLOW (gal/day):240

TYPE OF SYSTEM: New

SYSTEM DESIGN: Gravity w/ Gravelless Chambers

SEPTIC TANK CAPACITY(gal): 1000

DFLF/BED DIMENSIONS: 144

TRENCH DEPTH (inches): 32

TENCH WIDTH (inches): 36

APPURTANENCES:

PUMP CHAMBER (y/n):

PUMP CHAMBER GALLONS:

REASON SYSTEM DESIGN:

SPECIAL PERMIT INSTRUCTIONS:

FINAL INSPECTION DATE: 10/15/18 **Initials:** AC

Stevens County Office	**240 E Dominion**	**Colville,**	**WA**	**99114**	**(509) 684-2262**
Pend Oreille County Office	**605 Hwy 20**	**Newport,**	**WA**	**99156**	**(509) 447-3131**
Ferry County Office	**P.O. Box 584**	**Republic,**	**WA**	**99166**	**(509) 775-3111**

Northeast Tri County Health District

On-Site Sewage System As-Built Drawing for Permit # PT 18725

Inspection Date	10/15/18	**Approved** ☒ **Yes** ☐ **No**		**Approved Date**	10/15/18
Inspection By	Alice Campbell			**Re-Inspection Date**	—

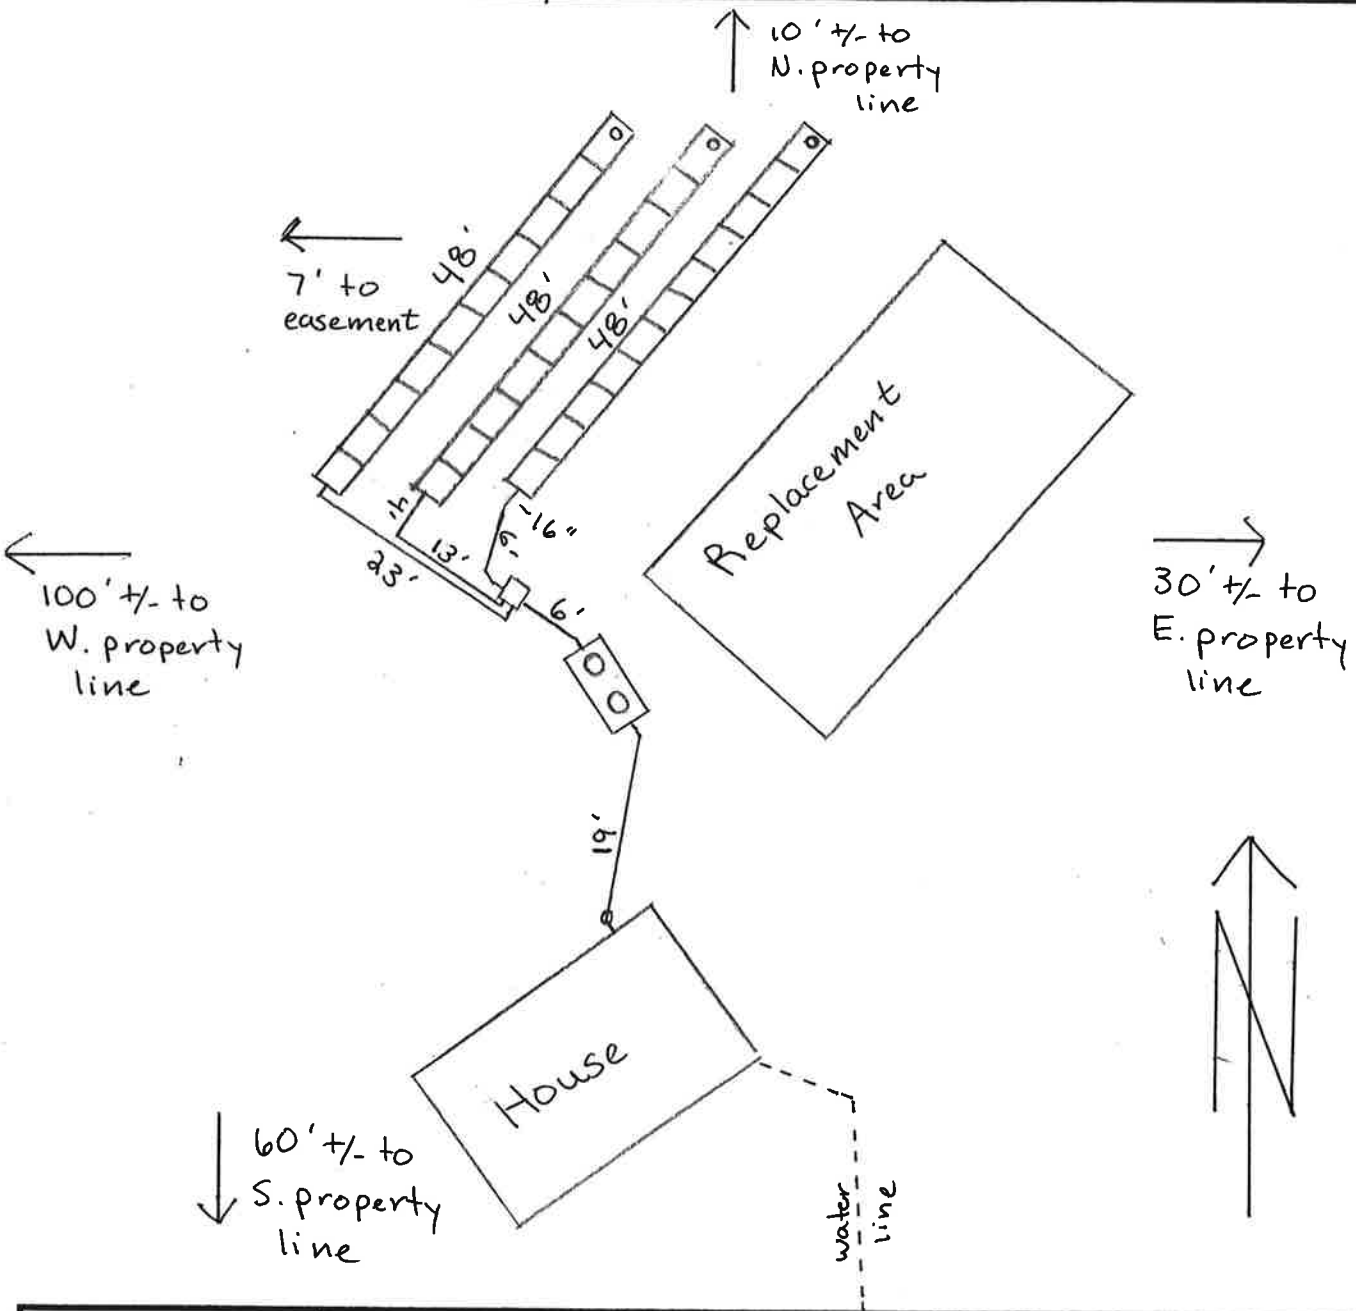

Installer Name	John Attwood		Pump Chamber Size		—
Septic Tank Size	1000g.	Dose/day	—	Gallons/Dose	—
Drainfield Length	144'	Squirt Height	—	Drawdown	—
Drainfield Depth	32"	Pump Run Time	—		
Septic Tank Latitude/Longitude	48.11577, -118.20352				