[illegible]: Directions:

DATE 8/9 FEE 10 — [illegible]

1. Dig a six foot deep soil log in the proposed drainfield area.
2. List below in general terms (examples: gravel, coarse sand, loam, sandy loam, clay, etc.) the types soil encountered and the depths they are found below ground surface.
3. Record the depth of any water, hardpan, or bedrock encountered in the soil log.
4. Record the depth to ground water, if known, of nearby wells.

SOIL TYPE	DEPTH (inches)
a. SANDY LOAM	5'
b. COARSE GRAVEL	-
c.	

Depth to water table: 180'

NAME: THOMAS PLANTEN (MIKE JUTICH) (property owner)

MAILING ADDRESS: 1029 ~~1055~~ OLYMPIC WAY BLDG. COLVILLE, WA.

LEGAL DESC.: ATTACHED (legal of property involved)

I certify that the soil tests were done as prescribed and that the above information is correct.

WAYNE PACHEC
Name of licensed installer

Wayne Pacheco
Signature of applicant

Phone: 4-5596 License No. _____ Phone: _____ Date: 8-9-78

PLOT PLAN (SQUARE = 20 FT.)

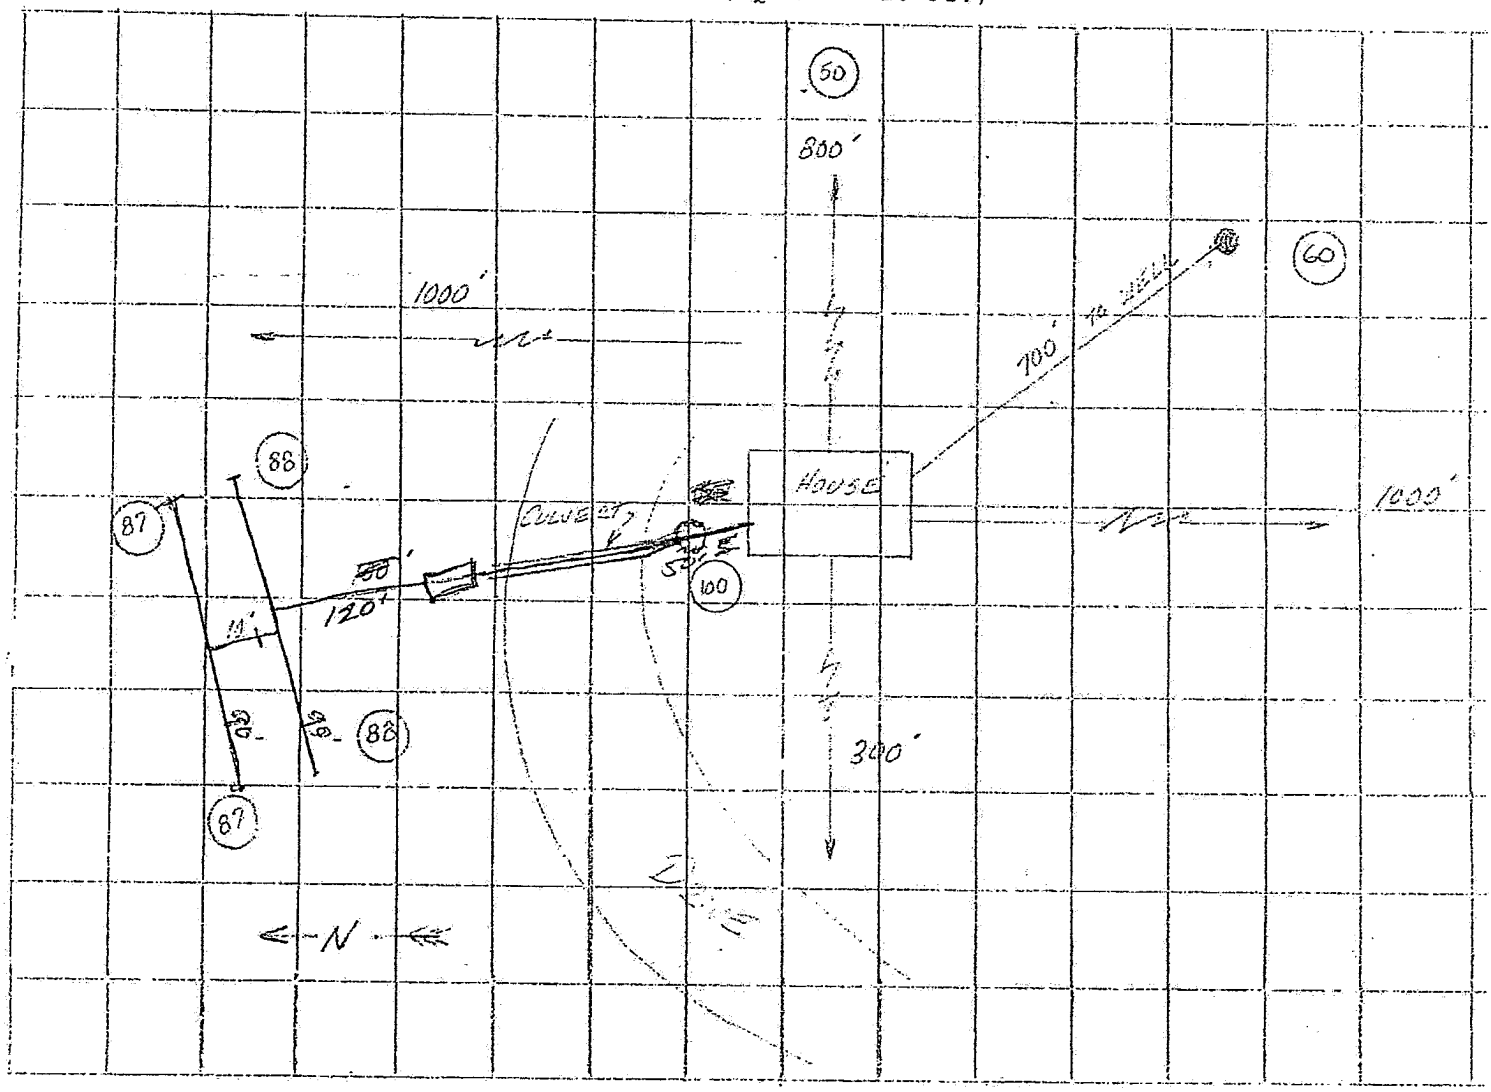

NUMBER OF BEDROOMS: 3 SYSTEM: New (X) Repair ( ) WATER: Public ( ) Private (X)

SEPTIC TANK:
Capacity 1000 gal.
Material CONCRETE (2 Compartment)
Total Acreage Owned: [illegible]

DRAINFIELD:
Total Linear Feet 180
Trench Depth 24" ft.
Trench Width [illegible]